

Monday, 11/02/2008 10:54:59 AM

User:

Linda Lacelle

**Process Sheet** 

Customer

: CU-DAR001 Dart Helicopters Services

Job Number : 37312 **Estimate Number** : 10782

P.O. Number

Prsht Rev.

Written By

This Issue

: 11/02/2008

S.O. No. :

: NC

: // First Issue **Previous Run** 

Checked & Approved By

: 35832

Type

: MACHINED PARTS

Material changed for Step 4KJ/JLM

**Part Number** 

**Drawing Name** 

**Drawing Number** 

**Project Number Drawing Revision** 

Material

**Due Date** 

: 14/02/2008

: FILLER

: D32087

: N/A

: A

: D3208 REV A

Qty:

Each

Comment **Additional Product** 

Job Number:



: Est: B04.05.25

Seq. #:

**Machine Or Operation:** 

Description: 6061-T6 .040 Sheet

1.0

M6061T6S040

0.0947 sf(s)/Unit Total: 1.1365 sf(s)

Comment: Qty.: Material: 2024-T3 (QQ-A-250/4) 0.040" thick


(M2024T3S.040)

Batch: 1633

2.0

3.0

SHEAR

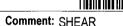

Cut blank: 2.750" x 4.300"

Identify for D3208-7

SMALL FAB 1

SMALL & MEDIUM FAB RESOURCE 1



Comment: SMALL & MEDIUM FAB RESOURCE 1

Drill and Fillet D3208-7corner as per Dwg D3208

Identify as D3208-7

4.0

BRAKE NC



Comment: NC BRAKE

Deburr D3208-7

Polish any marks on part within 01. of Dwg D3208



## **Dart Aerospace Ltd**

<b>W</b> /O:		WORK ORDER CHANGES								
DATE	STEP	STEP PROCEDURE CHANGE			Qty	Approval Chief Eng / Prod Mgr	Approval QC Inspector			

Part No: D3208-7 PAR #: NA Fault Category: Prod For Pass Mo DQA: Date: 08 02 14

NCR: 3	7312	WORK ORDER NON-CONFORMANCE (NCR)							
		Description of NC Corrective Action Section B				Verification	Approval	Approval	
DATE	STEP	Section A	Initial Chiene	Action Description Chief Eng	Sign & Date	Section C	Chief Eng	QC Inspector	
·		one part scrap	13	Scropan	æ		rSt		
. 1	华	cut out from water 5d	075-12	Destry no replay	8-24		88 aran	ىلى ا	
080011	20	at the hole water of R.C. Machin Malfuction		Q14 41		volalez	202	ublefiz	
								-	

NOTE: Date & initial all entries

Date: Monday, 11/02/2008 10:54:59 AM User: Linda Lacelle **Process Sheet Drawing Name: FILLER** Customer: CU-DAR001 Dart Helicopters Services Job Number: 37312 Part Number: D32087 Job Number: Seq. #: **Machine Or Operation: Description:** 5.0 QC5 INSPECT WORK TO CURRENT STEP Comment: INSPECT WORK TO CURRENT STEP HAND FINISHING HAND FINISHING RESOURCE #1 6.0 Comment: HAND FINISHING RESOURCE #1 Chemical Conversion Coat as per QSI 005 4.1 7.0 QC3 INSPECT POWDER COAT/CHEMICAL CONVERSION Comment: INSPECT CHEMICAL CONVERSION COAT 8.0 PACKAGING 1 PACKAGING RESOURCE #1 Comment: PACKAGING RESOURCE #1 Identify and Stock Location: 9.0 QC21 FINAL INSPECTION/W/O RELEASE Comment: FINAL INSPECTION/W/O RELEASE Job Completion

Dart Aerospace
----------------

Dart Ae	rospace	e Ltd			_			
W/O:			W	ORK ORDER CHANGES				
DATE	STEP	P PROCEDURE CHANGE		ANGE	Ву	Date Qty	Approval Chief Eng / Prod Mgr	Approva QC Inspector
Part No	•	PAR #:	_ Fault Cat	egory: NO	CR: Yes	No DQA:	Date: _	
					QA: N/	C Closed:	Date: _	
NCR:		W	ORK ORI	DER NON-CONFORMANC	E (NCR)	)		
		Description of NC		Corrective Action Section B		Verification	Approval	Approval
DATE	STEP	Section A	Initial Chief Eng	Action Description  Chief Eng	Sign & Date	Section C	Chief Eng	QC Inspector
	1		1		1	1	1	1

NCR:			WORK ORDI	ER NON-CONFORMAN	CE (NCK)								
		Description of NC Corrective Action			1 Section B			A					
DATE	STEP	Section A	Initial Chief Eng	Action Description Chief Eng	Sign & Date	Verification Section C	Approval Chief Eng	Approval QC Inspector					
-													
			1										


NOTE: Date & initial all entries








DESIGN	DRAWN BY		OSPACE LTD ONTARIO, CANADA
CHECKED	APPROVED	DRAWING NO.	REV. A SHEET 1 OF 3
DATE		TITLE	SCALE
04.01.27		DOUBLER	1:3

A	04.01.27 REW ISSUE
	10. 10. 10. 10. 10. 10. 10. 10. 10. 10.
Ai	+ TO OH, 05.25 CHANGE DIM ; NOTE 3) CHANG

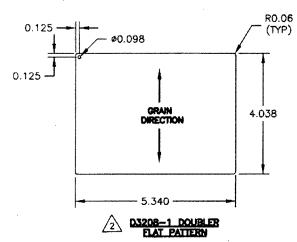

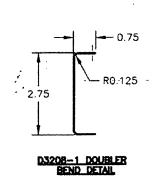

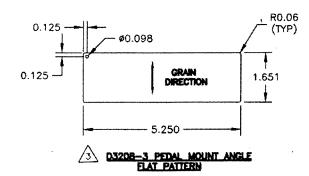

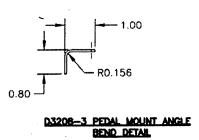

- 1) BREAK ALL UNMARKED SHARP EDGES 0.005 TO 0.010

- 2) MATERIAL: 2024-T3 (QQ-A-250/4) 0.040" THICK (M2024T3S.040)
  3) MATERIAL: 2024-T3 (QQ-A-250/4) 0.063" THICK (M2024T3S.063)
  4) MATERIAL: 2024-T3 (QQ-A-250/4) 0.080" THICK (M2024T3S.080)
  5) FINISH: CHEMICAL CONVERSION COAT PER DART OF THE PART OF
- 6) TOLERANCES ARE PER DART QSI 018 UNLESS OTHERWISE NOTED
- 7) ALL DIMENSIONS ARE IN INCHES

IN PRATERIOR GOLD TE LODG - A - DRIVAT CLOSS THEFT (MENTERS IN )

Copyright © 2004 by DART AEROSPACE LTD


THIS DOCUMENT IS PRIVATE AND CONFIDENTIAL AND IS SUPPLIED ON THE EXPRESS CONDITION THAT IT IS NOT TO BE USED FOR ANY PURPOSE OR COPIED OR COMMUNICATED TO ANY OTHER PERSON WITHOUT WRITTEN PERMISSION FROM DART AEROSPACE LTD.






DESIGN A	DRAWN BY		ROSPACE LTD , ONTARIO, CANADA
снескер,	APPROVED	DRAWING NO.	REV. A
-4		D3208	SHEET 2 OF 3
DATE		TITLE	SCALE
04.01.27		DOUBLER	1:2




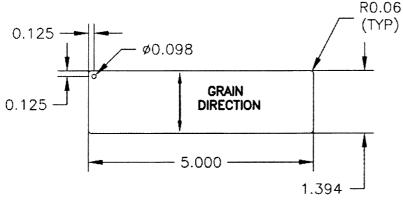

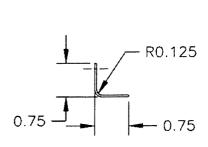

D3208-5 MOUNT ANGLE BEND DETAIL

D3208-5 MOUNT ANGLE FLAT PATTERN

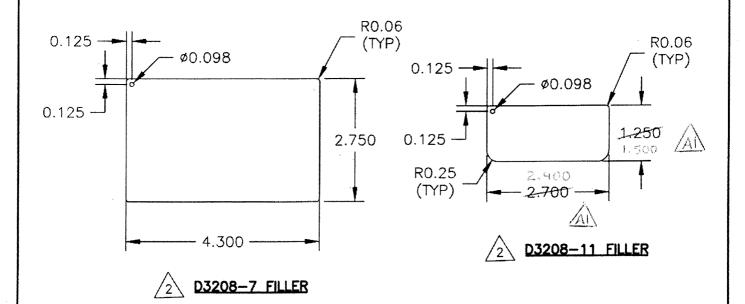

Copyright © 2004 by DART AEROSPACE LTD


THIS DOCUMENT IS PRIVATE AND CONFIDENTIAL AND IS SUPPLIED ON THE EXPRESS CONDITION THAT IT IS NOT TO BE USED FOR ANY PURPOSE OR COPIED OR COMMUNICATED TO ANY OTHER PERSON WITHOUT WRITTEN PERMISSION FROM DART AEROSPACE LTD.





DESIGN	DRAWN BY		ROSPACE LTD RY, ONTARIO, CANADA
CHECKED	APPROYED	DRAWING NO.	REV. A
#	##	D3208	SHEET 3 OF 3
DATE		TITLE	SCALE
04.01.27		DOUBLER	1:2



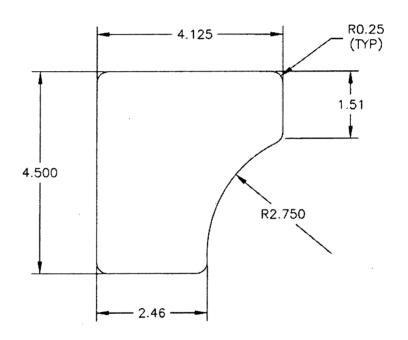



D3208-9 DOUBLER

Copyright © 2004 by DART AEROSPACE LTD

THIS DOCUMENT IS PRIVATE AND CONFIDENTIAL AND IS SUPPLIED ON THE EXPRESS CONDITION THAT IT IS NOT TO BE USED FOR ANY PURPOSE OR COPIED OR COMMUNICATED TO ANY OTHER PERSON WITHOUT WRITTEN PERMISSION FROM DART AEROSPACE LTD.

DART AEROSPACE LTD	Work Order: 37312
Description: FILLER	Part Number: D3408~
Inspection Dwg: D3968-7 Rev: A	Page 1 c

## FIRST ARTICLE INSPECTION CHECKLIST

X First Article	Prototype
-----------------	-----------

Drawing Dimension	Tolerance	Actual Dimension	Accept	Reject	Method of Inspection	Comments
ø , ०५४	+ 004 -001	, (00	*			
1192	1/2.010	, l3c	يرا			
.125	1/010	·	×			
8.130	400	· · · · · · · · · · · · · · · · · · ·	×			
	4-,010	4.300	ケ	<u> </u>	<u> </u>	,
					<u> </u>	
<u> </u>	:			<del> </del>		·
			· · · · · · · · · · · · · · · · · · ·	ļ		
				ļ		
			· · · · · · · · · · · · · · · · · · ·			
			~			
				-		
	.:		<del></del>			
			·	· .		
				1		

		·		
Measured by: R	Audited by:	Prototype Approval:	a/	
Date: 8-2-11	Date: 08(2/12	Date:	19	_

				•
Rev	Date	Change	 Revised by	Approved
0 1				*
: A ;		New Issue	KJ/JLM	i f
			 LODEN:	i